


REVISED 2/23/2022


Cable Types

- CAT 5e — Installed DMX (Cat 5)
- DMX → Installed DMX (2 pair)
- DMX → Portable DMX (XLR)
- 24v Power (2x 16 ga)



Schematic DMX signal flow for each universe

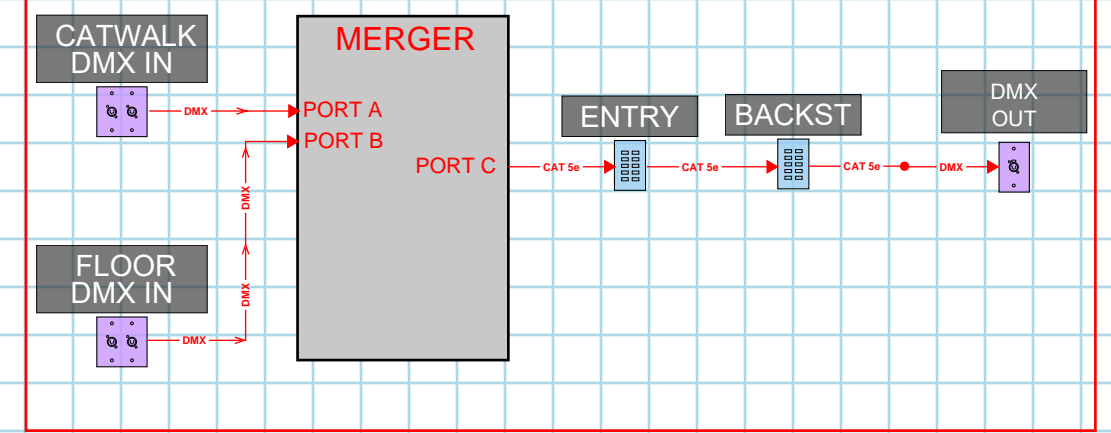

Catwalk Plug-in Station

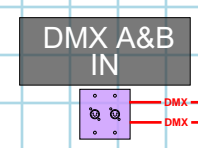

Entry Button Stations

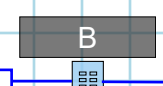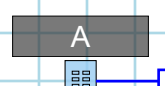

Backstage Button Stations

